


NBP2 PROCESS-WATER BOOSTER STATION - AS-BUILT PIPING ISOMETRIC

Drawing: NBP2-PW-ISO-004 | Revision: 4 AS-BUILT | Issued: 2026-03-29 | Status: IFC / AS-BUILT

Simplified process arrangement (not to scale)

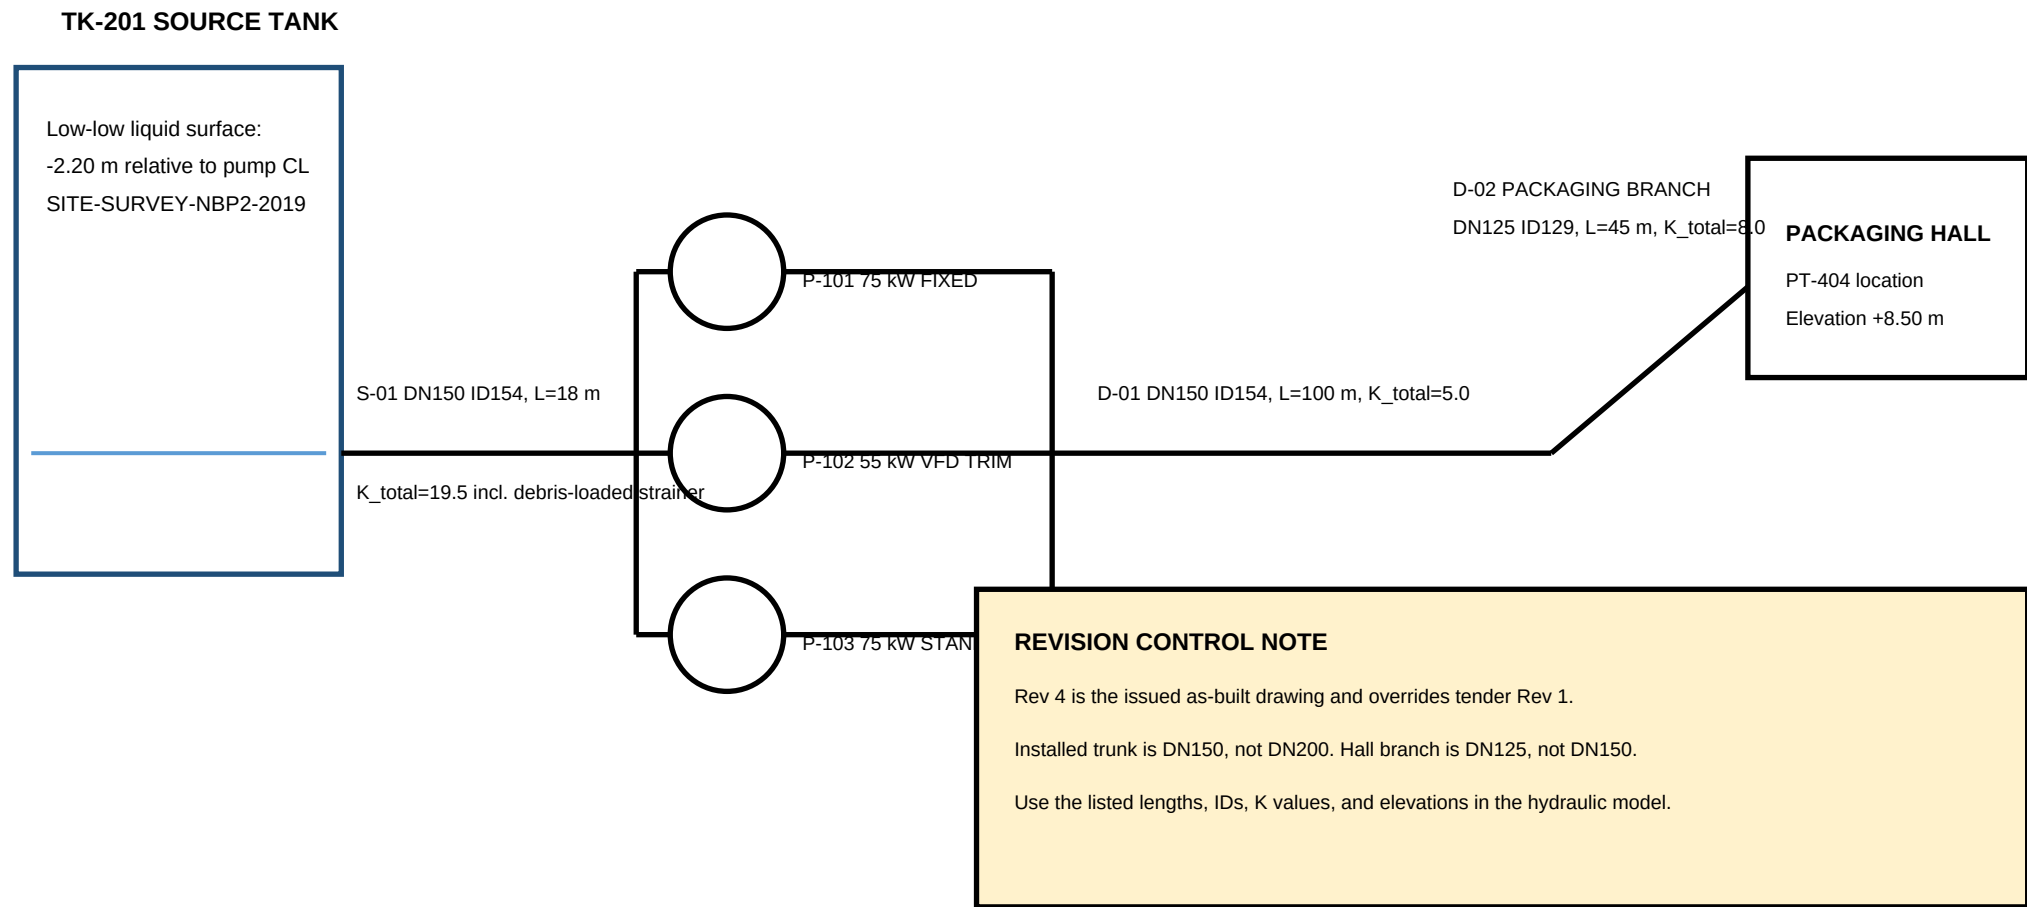

NBP2 PROCESS-WATER BOOSTER STATION - AS-BUILT LINE SCHEDULE

Drawing: NBP2-PW-ISO-004 | Revision: 4 AS-BUILT

Line	Service	From	To	ID (mm)	Length (m)	Darcy f	K total	Elevation / note
S-01	Tank suction	TK-201	Pump suction header	154	18	0.024	19.5	As-found event basis incl. debris-loaded strainer
D-01	Main discharge	Pump discharge header	Packaging branch tee	154	100	0.022	5.0	Use for governing hall path
D-02	Packaging-hall branch	Packaging branch tee	PT-404 hall location	129	45	0.023	8.0	PT-404 elevation +8.50 m relative pump CL
D-03	Utility branch	Main header	Washdown skid	104	36	0.024	6.0	Not on governing packaging-hall path

Deliberate conflict retained for assessment

Tender drawing NBP2-PW-TDR-001 Rev 1 listed a DN200 discharge trunk and DN150 packaging branch.

Those sizes were reduced during construction. Rev 4 is the signed as-built record and must control the hydraulic model.

The as-found suction-strainer K total is used only for the event reconstruction. Clean-strainer verification remains an open item.

NBP2 PROCESS-WATER BOOSTER STATION - REVISION HISTORY AND FIELD NOTES

Drawing: NBP2-PW-ISO-004 | Revision: 4 AS-BUILT

Revision	Date	Status	Summary	Authority
1	2025-06-03	TENDER	DN200 trunk and DN150 packaging branch shown for preliminary tendering.	Superseded
2	2025-09-11	FIELD CHANGE	Pipe sizes reduced after route coordination.	Superseded
3	2026-01-20	REDLINE	Measured lengths and elevations updated.	Superseded
4	2026-03-29	AS-BUILT / IFC	Installed sizes, lengths, K values, and packaging-hall elevation verified.	Controlling record

Field note: suction strainer loss

No permanent differential-pressure transmitter is installed across the suction strainer.

After the 14 May event, debris loading was observed. The event reconstruction therefore uses the as-found K_{total} of 19.5.

A clean-strainer differential-pressure verification is required before purchase-order release and commissioning acceptance.